



CONTACT INFORMATION

Mining Records Curator
Arizona Geological Survey
1520 West Adams St.
Phoenix, AZ 85007
602-771-1601
<http://www.azgs.az.gov>
inquiries@azgs.az.gov

The following file is part of the

Arizona Department of Mines and Mineral Resources Mining Collection

ACCESS STATEMENT

These digitized collections are accessible for purposes of education and research. We have indicated what we know about copyright and rights of privacy, publicity, or trademark. Due to the nature of archival collections, we are not always able to identify this information. We are eager to hear from any rights owners, so that we may obtain accurate information. Upon request, we will remove material from public view while we address a rights issue.

CONSTRAINTS STATEMENT

The Arizona Geological Survey does not claim to control all rights for all materials in its collection. These rights include, but are not limited to: copyright, privacy rights, and cultural protection rights. The User hereby assumes all responsibility for obtaining any rights to use the material in excess of "fair use."

The Survey makes no intellectual property claims to the products created by individual authors in the manuscript collections, except when the author deeded those rights to the Survey or when those authors were employed by the State of Arizona and created intellectual products as a function of their official duties. The Survey does maintain property rights to the physical and digital representations of the works.

QUALITY STATEMENT

The Arizona Geological Survey is not responsible for the accuracy of the records, information, or opinions that may be contained in the files. The Survey collects, catalogs, and archives data on mineral properties regardless of its views of the veracity or accuracy of those data.

ARIZONA DEPARTMENT OF MINES AND MINERAL RESOURCES AZMILS DATA

PRIMARY NAME: DENVER MINE

ALTERNATE NAMES:
EL TORO

SANTA CRUZ COUNTY MILS NUMBER: 99

LOCATION: TOWNSHIP 23 S RANGE 15 E SECTION 2 QUARTER SW
LATITUDE: N 31DEG 27MIN 04SEC LONGITUDE: W 110DEG 47MIN 06SEC
TOPO MAP NAME: NOGALES - 15 MIN

CURRENT STATUS: PAST PRODUCER

COMMODITY:
LEAD
SILVER

BIBLIOGRAPHY:
USGS NOGALES QUAD
AZBM CARD FILE SANTA CRUZ CO.
ADMMR DENVER MINE FILE

EL TORRO


SANTA CRUZ COUNTY

GWI WR 10/22/76: John Taylor wanted the name of the tunnel in upper Maggies Canyon, Santa Cruz County. Told him that it was listed as the Denver Mine on the topo maps. He said that two men were working there and they called it the El Torro.

GWI WR 2/2/77: Ed Chamberlain reported that the El Torro mine was driving a decline, that the owners live in Patagonia.

VBD WR 3/3/77: The El Torro Mine in the Harshaw Mining District of Santa Cruz County is owned and operated by Bob James and James Schmitz. A new discovery of lead-silver ores have been made. The owners are searching for a market for the ores. The property is near the western boundary of the big Kerr-McGee property.

RRB WR 9/21/84: Herbert Kuglmeier, P O Box 26831, Albuquerque, NM 87125 reports that he had acquired the Denver Mine, Santa Cruz Co. and wanted to get enough information about it and the surrounding mines to determine if it was feasible to build a mill. I suggested that he would have to do an extensive sampling and/or drilling program to delineate the ore body before he could tell if it was feasible to build a mill.

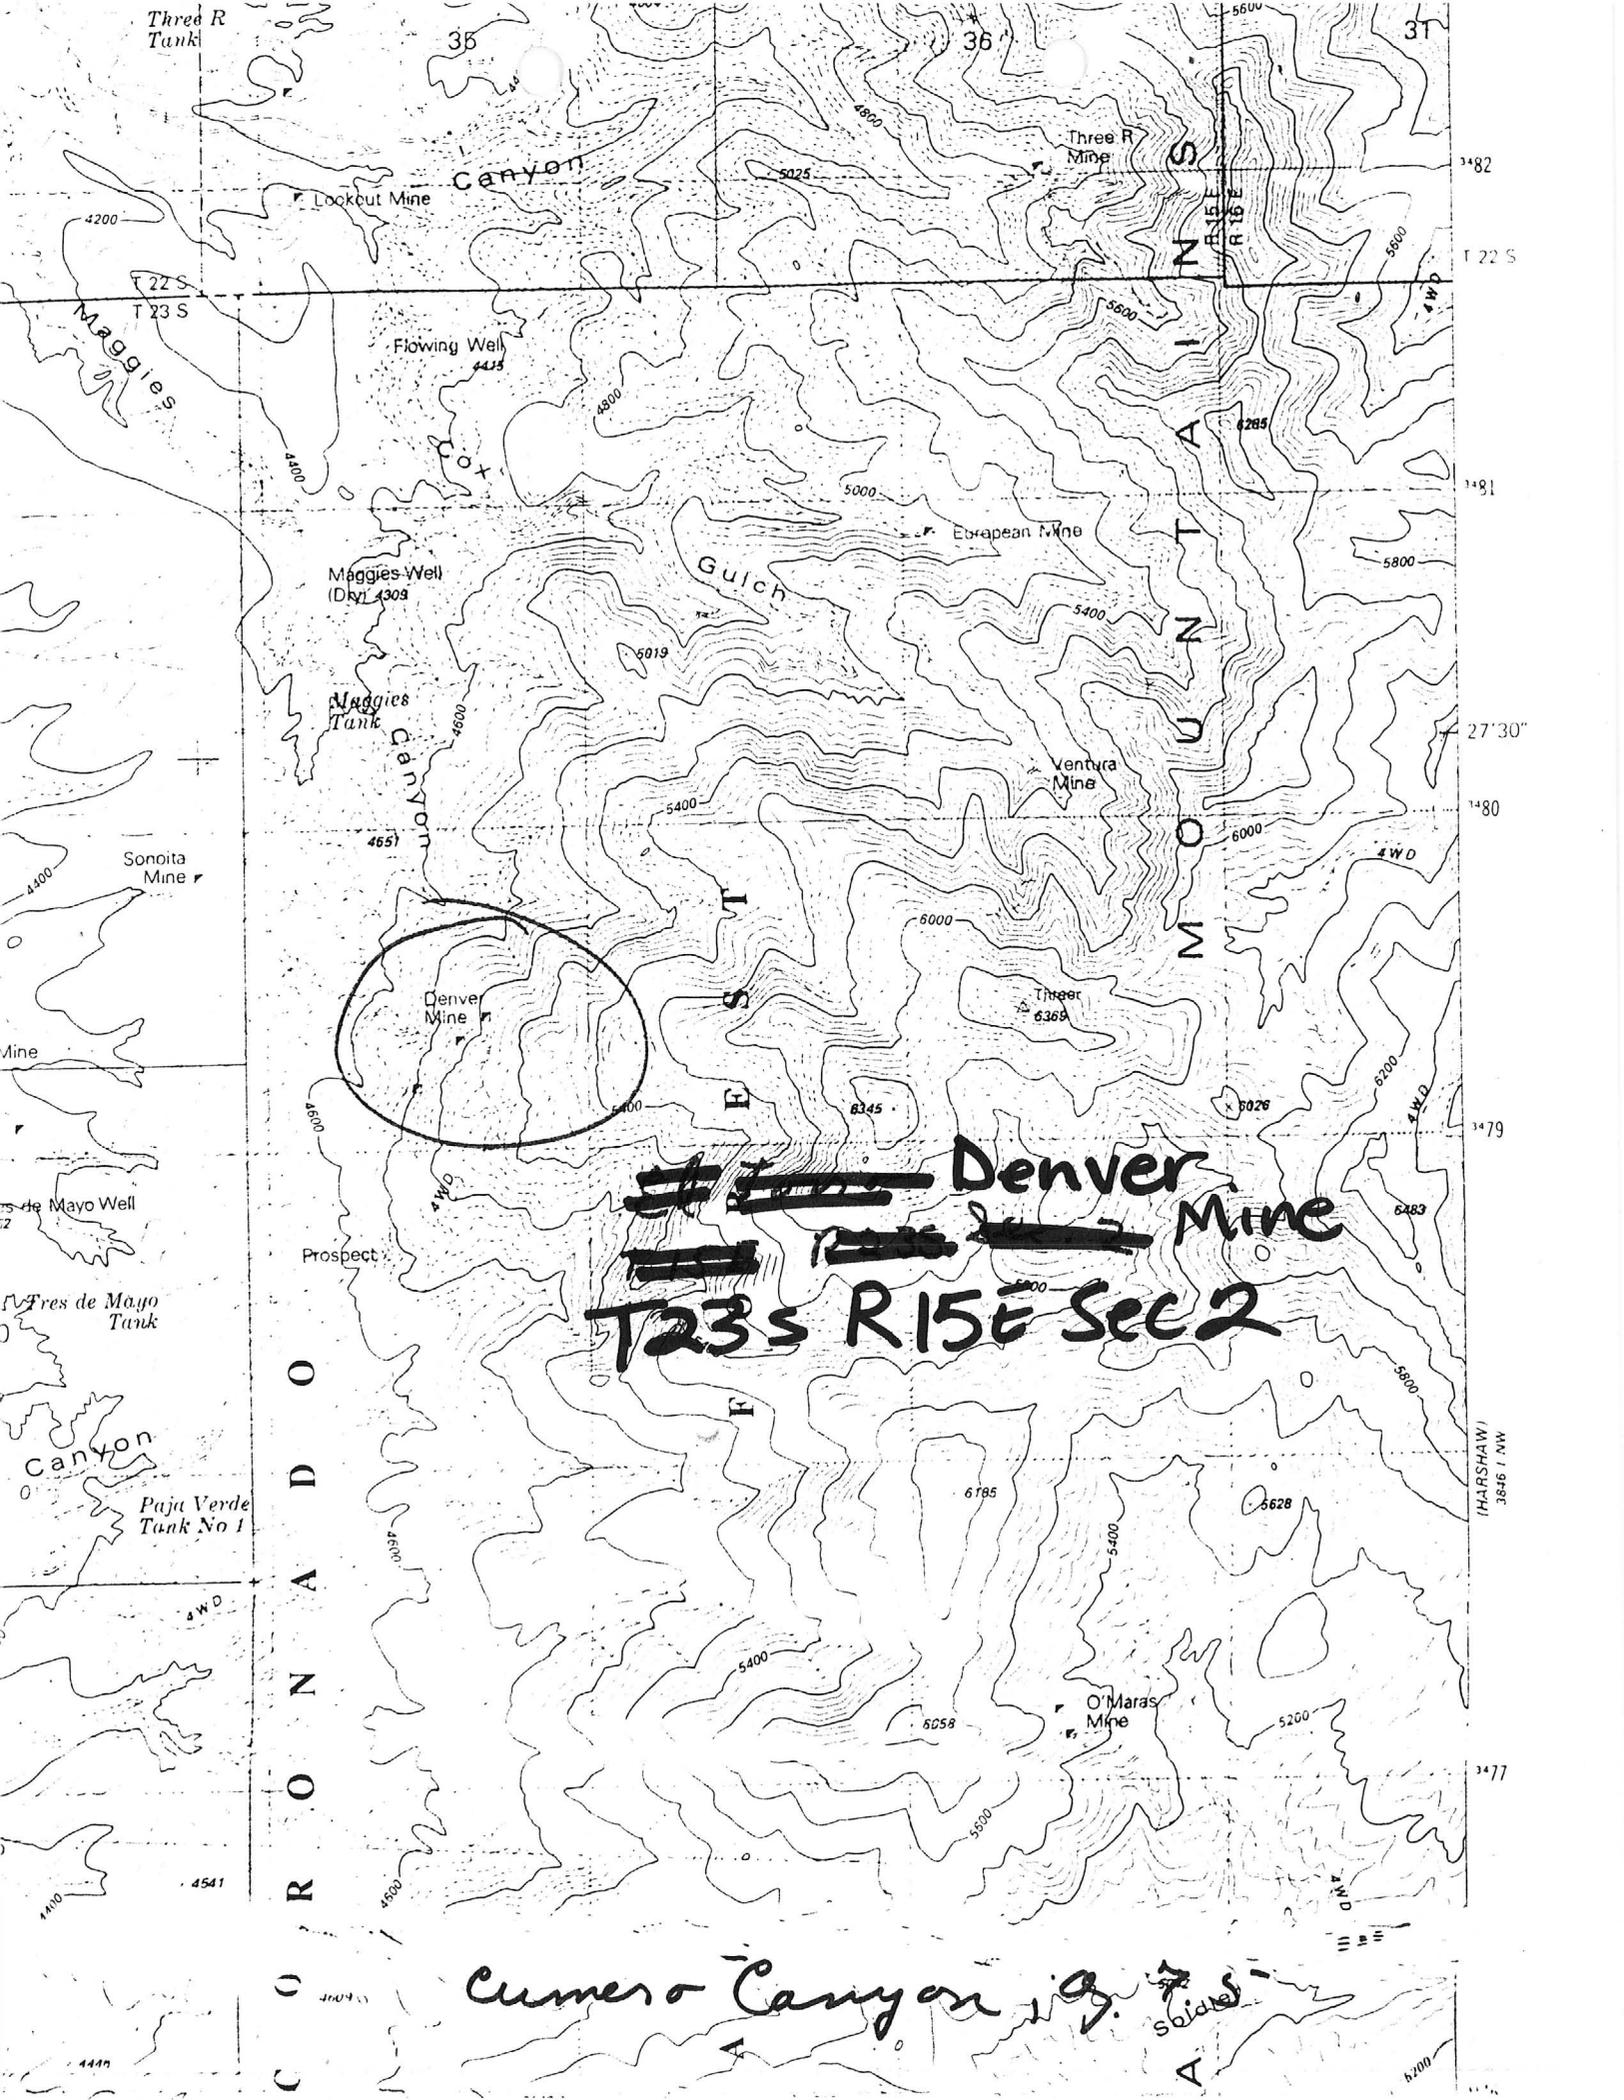

Three R Tank

35

36

3T

Canyon

Three R Mine

Lookout Mine

S
E
C
T
I
O
N

1482

T 22 S

1481

Flowing Well 4435

European Mine

6285

Maggie's Well (Dry) 4309

Gulch

S
E
C
T
I
O
N

27' 30"

1480

Maggie's Tank

Ventura Mine

Sonoita Mine

Denver Mine

Three 6365

S
E
C
T
I
O
N

1479

~~Denver Mine~~
~~Denver Mine~~
Denver Mine
T23S R15E Sec 2

Prospect

6483

C
O
L
O
R
A
D
O

1478
HARSHAW

Canyon

Paju Verde Tank No 1

O'Maras Mine

1477


Cumero Canyon 19. 7. 1915


1476

Map as Drawn
for
Monarch Mining & Milling Co.
Greater Denver Group

Scale - 1" = 400 ft.
Original map at Bureau of Mines in Tucson
Drawn by M.H.J. Birren, Engr. 1923
Copied by Wes Donaldson 1983
I drew in the Road

- #1 Long Cross Cut Tunnel
 - #2 Denver Camp
 - #3 Tres de Mayo Shaft
 - #4 OLD Tunnel Hassayampa #2
 - #5 New Tunnel " #2
 - #6 OLD La Palma Shaft from where high grade silver was shipped to Denver, Colo.
 - #7 OLD La Palma Shaft from where high grade silver was shipped to Denver, Colo.
- Boundary Line of Tres de Mayo Claims now owned by Wes Donaldson

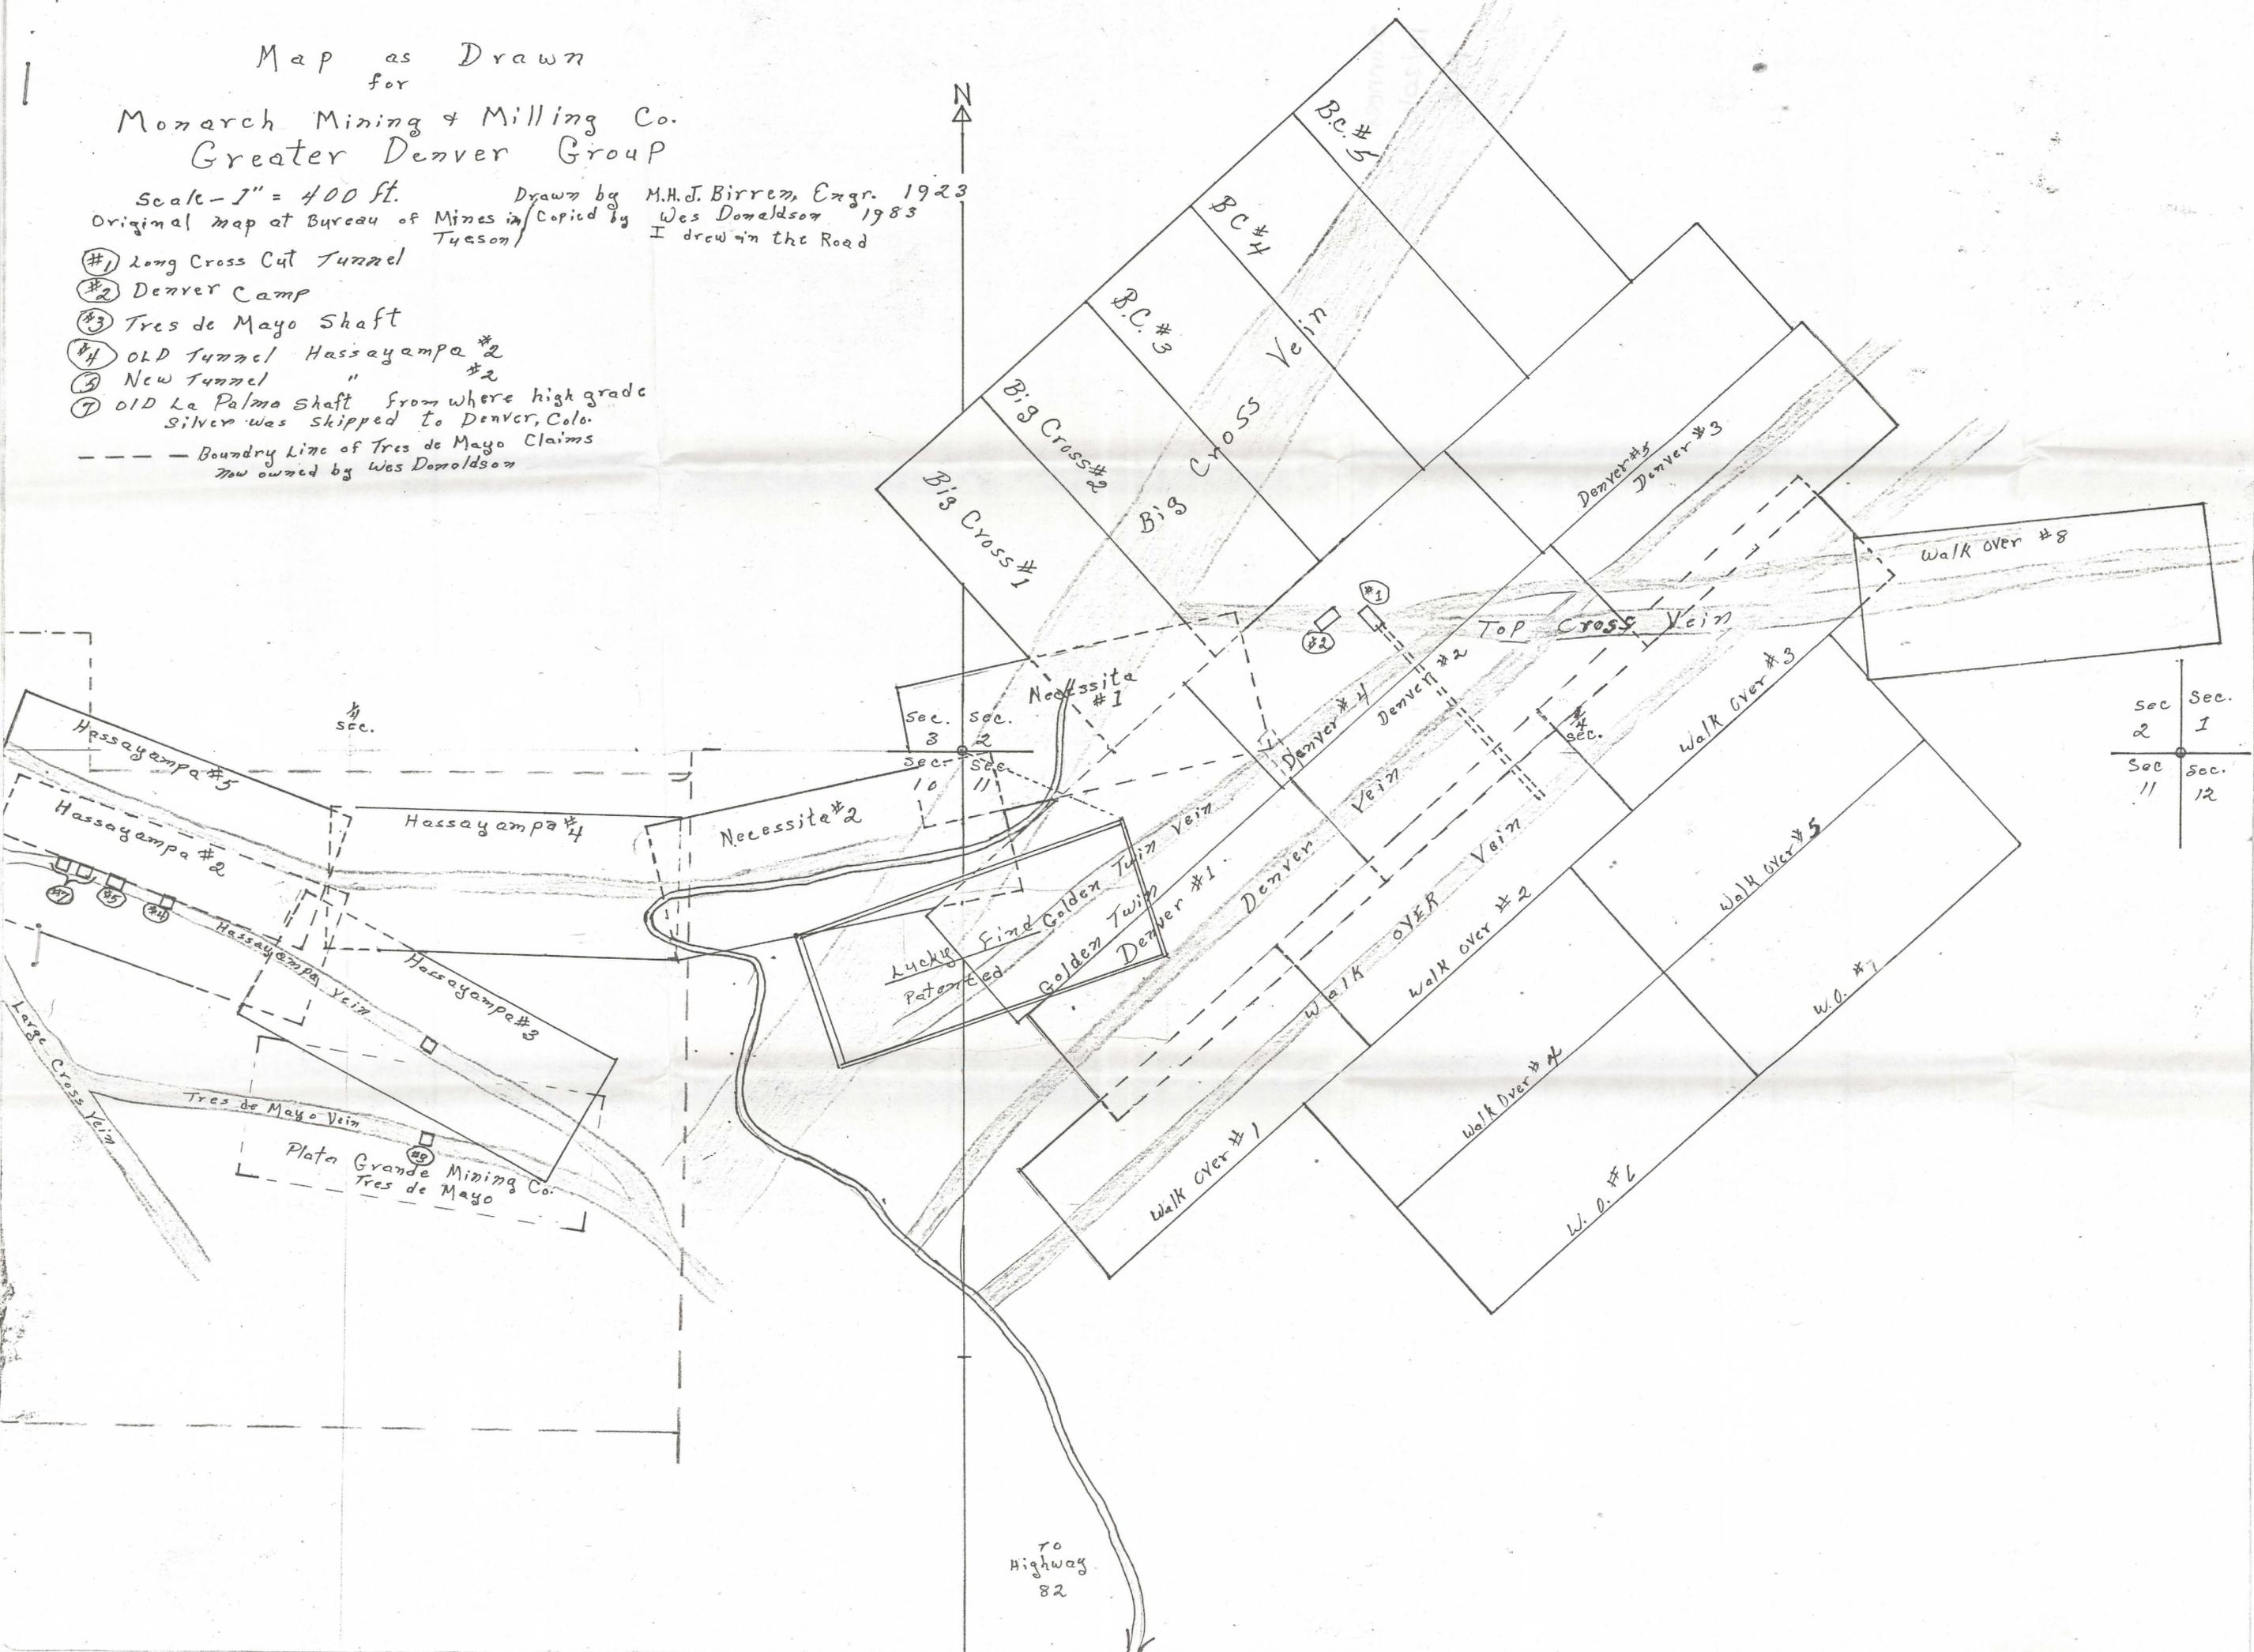

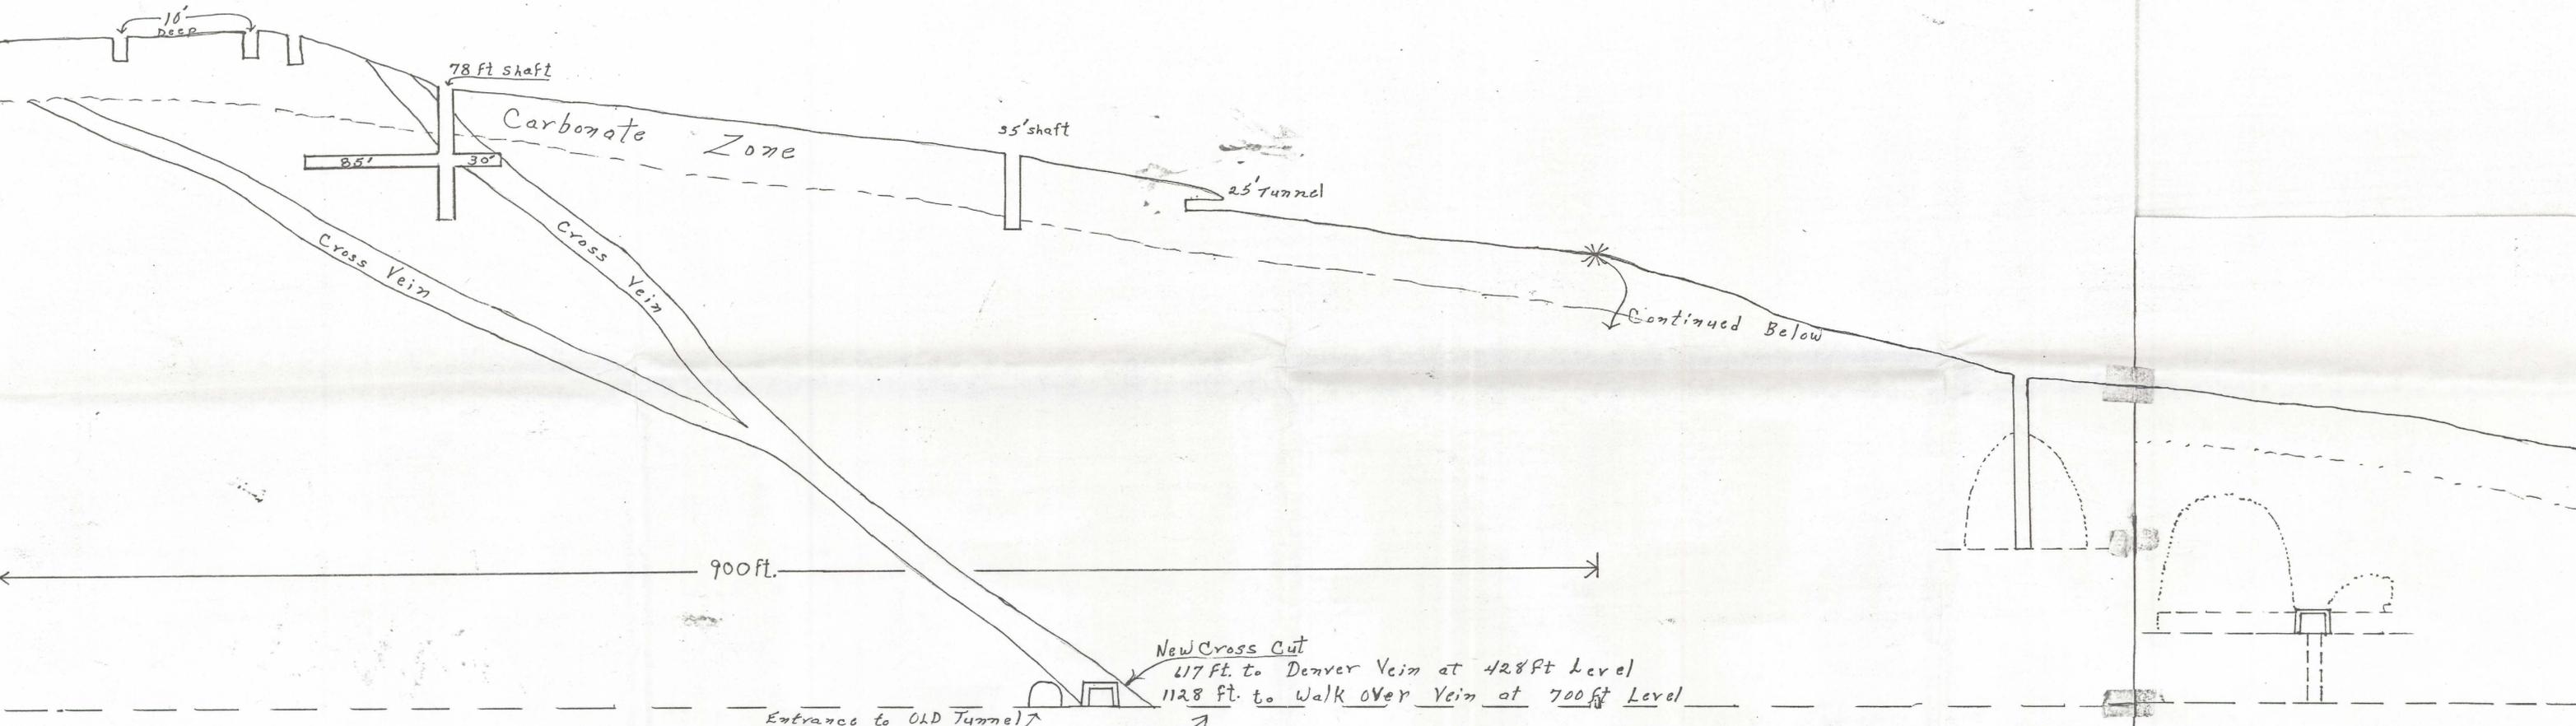


Entrance to OLD Tunnel

New Cross Cut
 417 ft. to Denver Vein at 428 ft Level
 1128 ft. to Walk over Vein at 700 ft Level

Continued from above

Cross Sectional View
 Drawn for
 Monarch Mining + Milling Co.
 Scale - 1 inch = 50 ft. May 11, 1923
 Copied by: Wes Donaldson - Dec. 1983

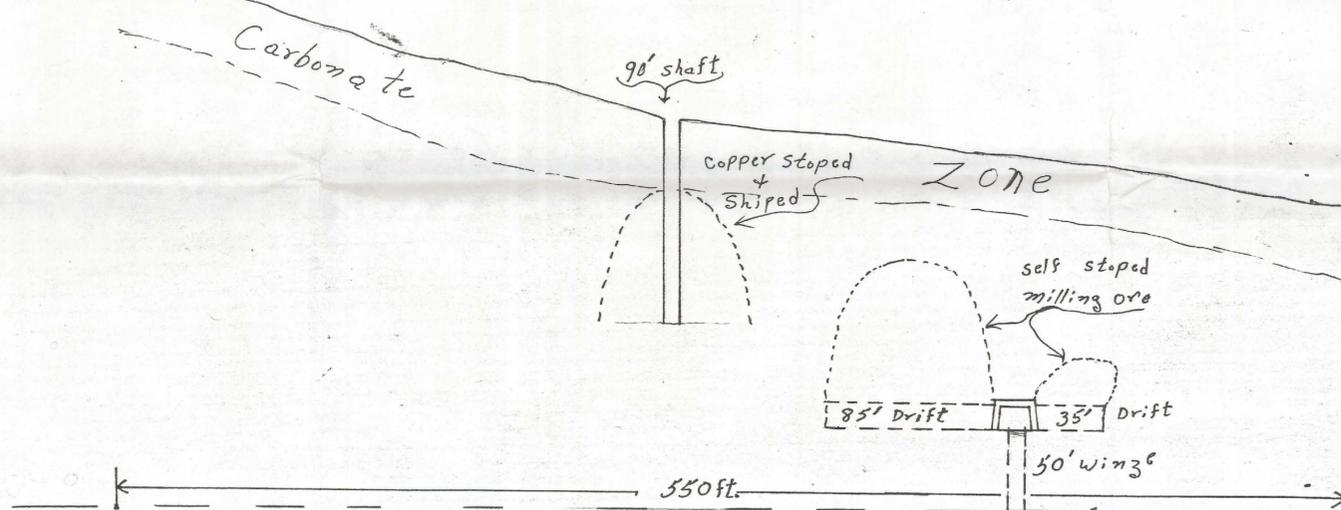

Cross Cut 130 ft - Cutting Vein at
 153 ft. depth showing Vein 8 ft
 wide, carrying .28% Au - 12% Ag
 5.75% Pb + 2.5% Cu