


MAPS FROM FILES OF
E. ROSS HOUSHOLDER
ENGINEER & LAND SURVEYOR

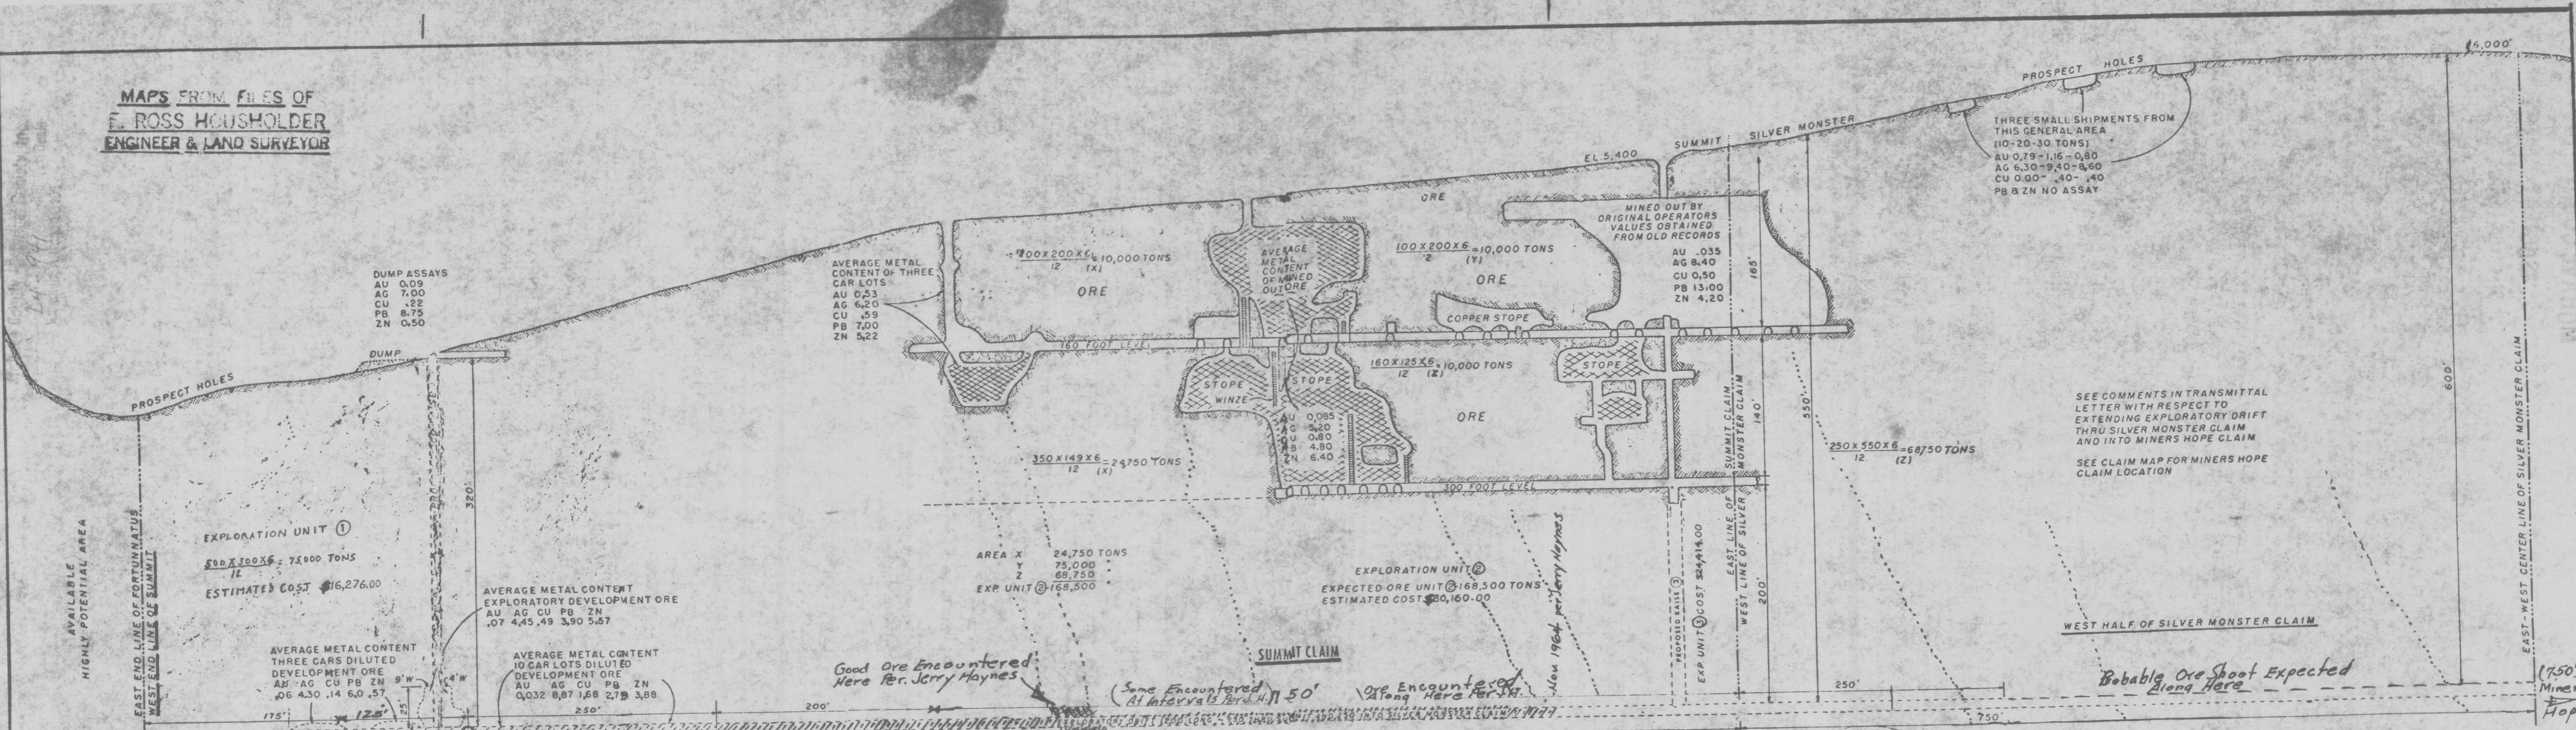

THREE SMALL SHIPMENTS FROM THIS GENERAL AREA (10-20-30 TONS)
AU 0.79-1.16-0.80
AG 6.30-9.40-8.60
CU 0.00-.40-.140
PB 8 ZN NO ASSAY

SEE COMMENTS IN TRANSMITTAL LETTER WITH RESPECT TO EXTENDING EXPLORATORY DRIFT THRU SILVER MONSTER CLAIM AND INTO MINERS HOPE CLAIM
SEE CLAIM MAP FOR MINERS HOPE CLAIM LOCATION

Good Ore Encountered Here Per. Jerry Haynes

Some Encountered At Intervals Per. J.H.

Ore Encountered Along Here Per. J.H.

Probable Ore Shoot Expected Along Here


(750') Miners Hope

Note: Details; And Assays; Tonnage; Et. Al; Obtained From Office Records Of Summit Mine.
E.R.H.

EXPECTED EXPLORATION UNIT 1 75,000 TONS
DISCOVERIES @ 168,500
OF NEW ORE 243,500
OVERALL COST \$120,550.00
COST PER TON OF EXPECTED ORE 40¢

SECTIONAL MAP

SECTIONAL MAP
SUMMIT AND SILVER MONSTER CLAIMS
of
SUMMIT MINE GROUP
(Looking Northeasterly)

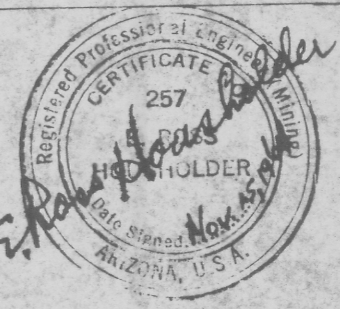

Sketch Map To Accompany Report
By: E. Ross Housholder, E.M.
Reg. Professional Engineer #257
P.O. Box 1107, Kingman, Arizona
Scale 1" = 100' Nov. 15, 1964

ADMMR 0276-004