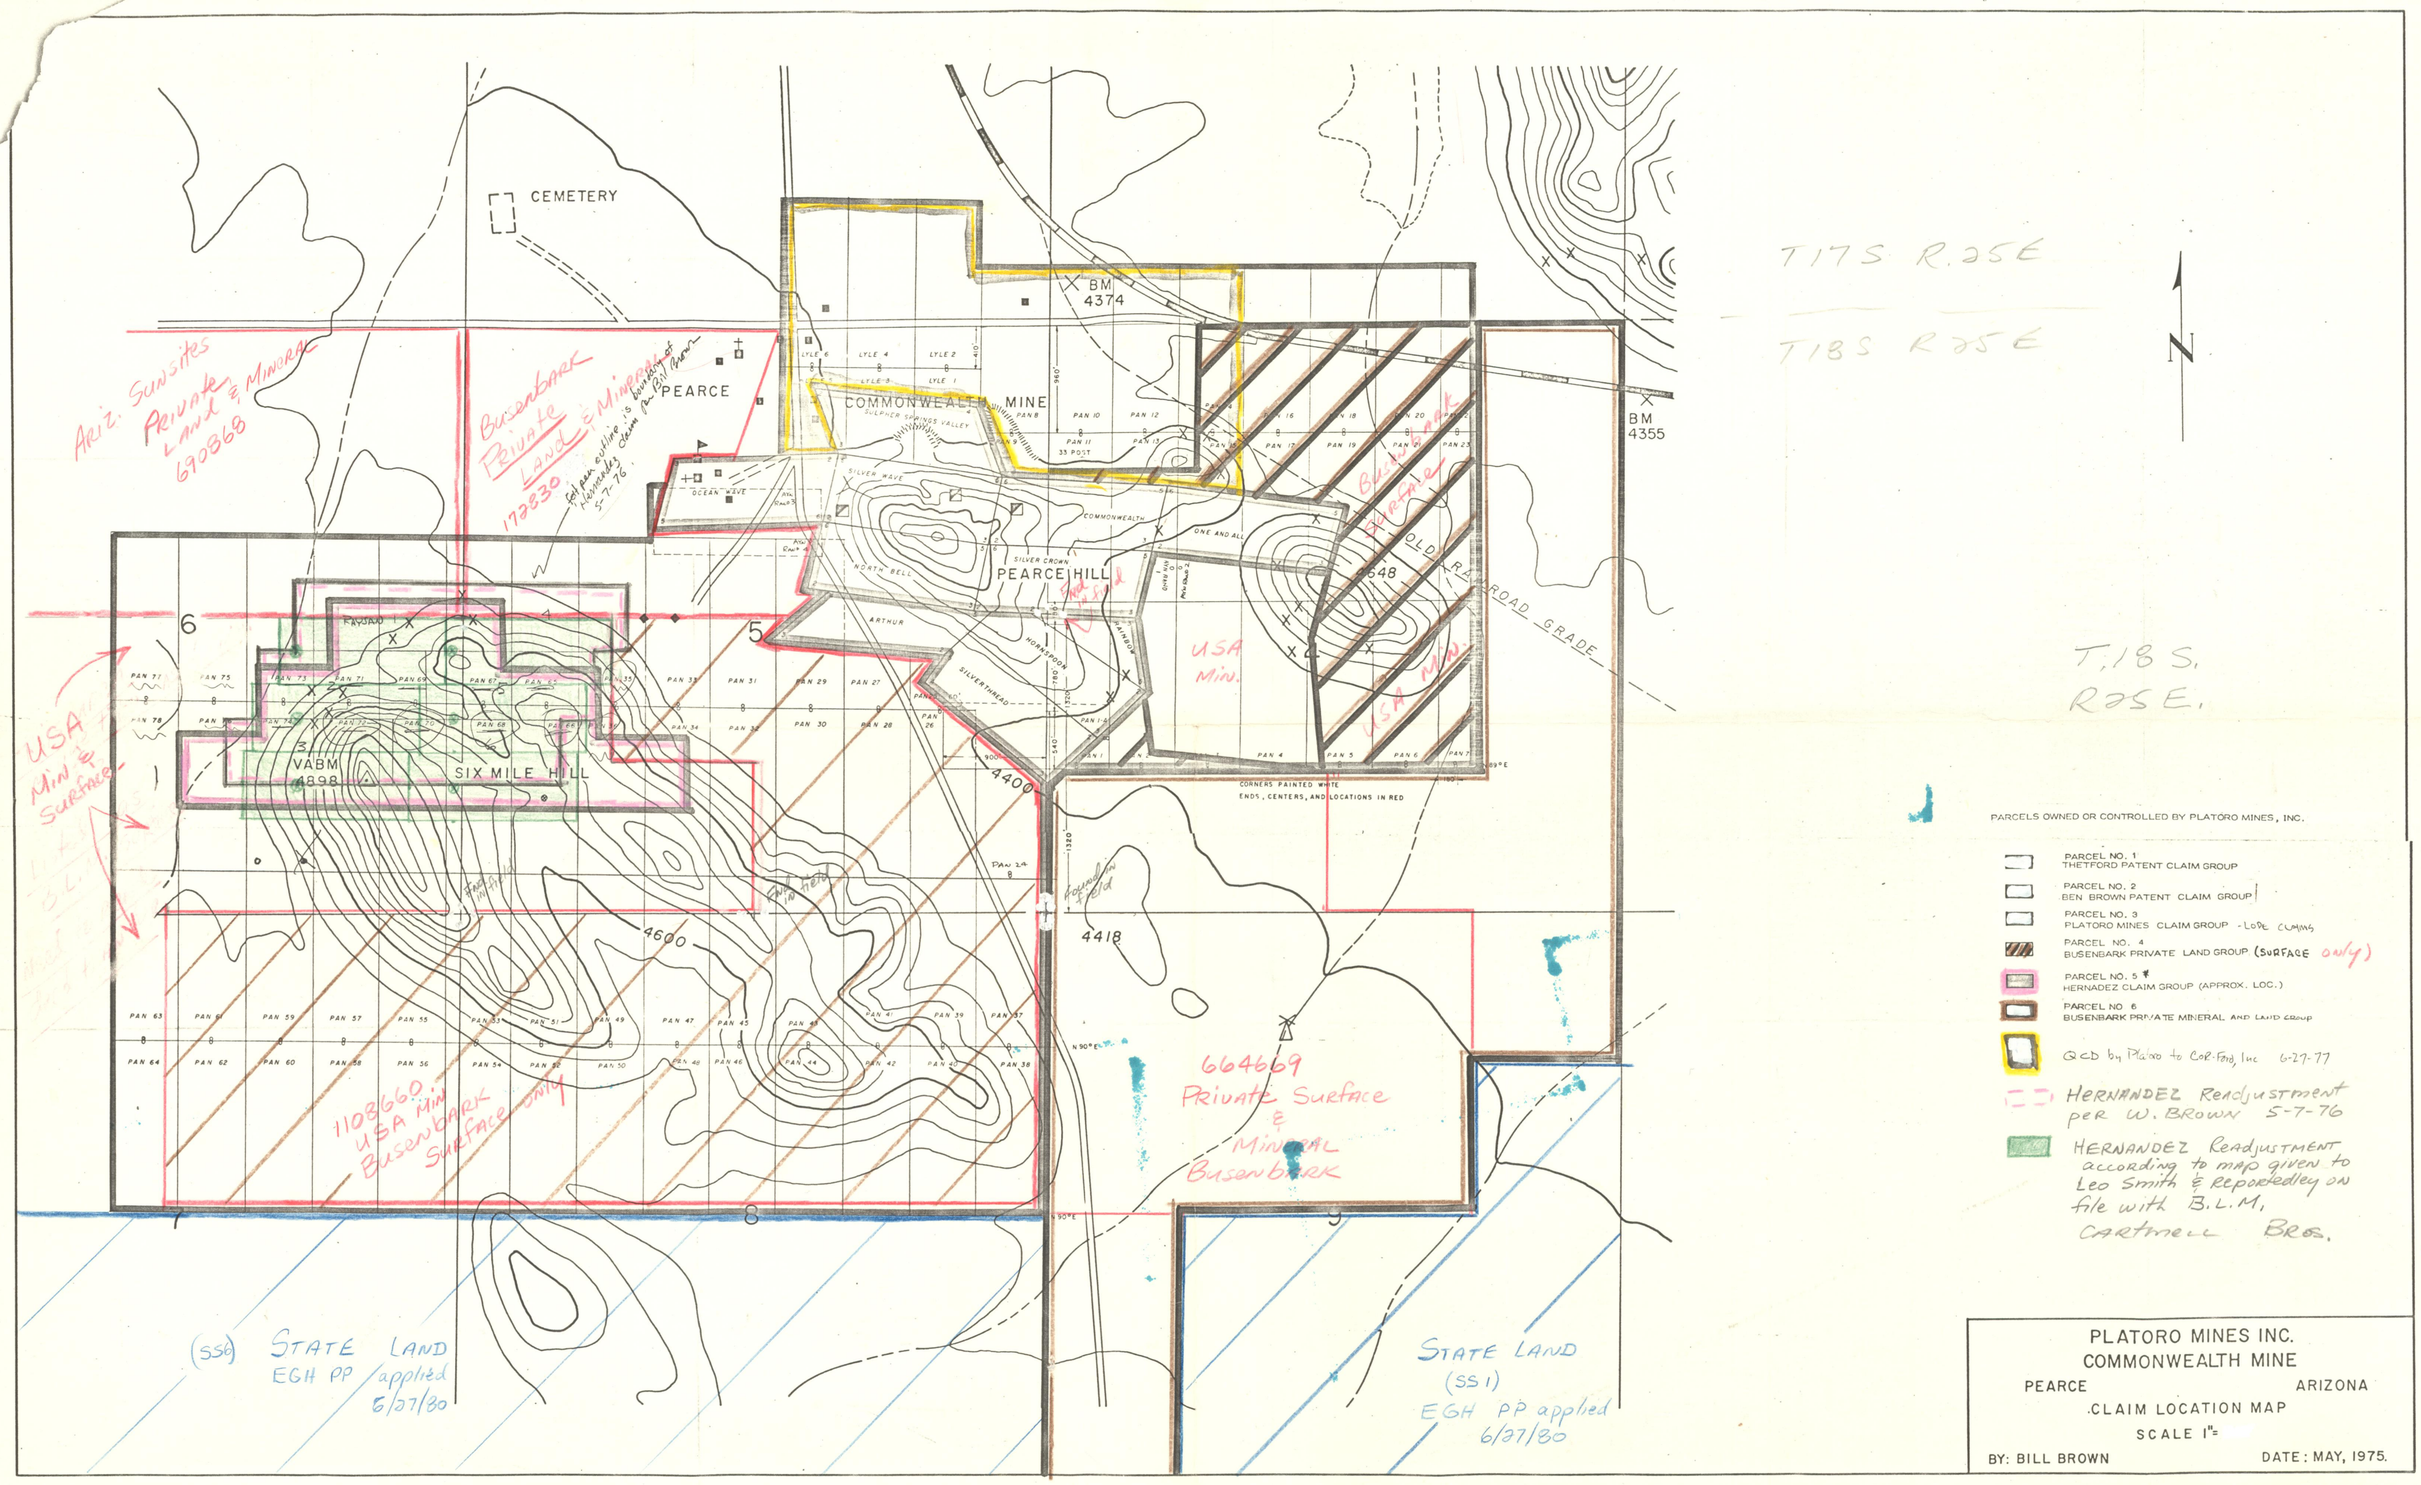

CEMETERY
PEARCE
COMMONWEALTH MINE
PEARCE HILL
SIX MILE HILL
VABM 4898
BM 4374
BM 4355
OLD RAILROAD GRADE
Ariz. Sunsites Private Land & Mineral 690868
Busenbark Private Land & Mineral 172830
USA Min. & Surface
USA Min.
Busenbark Surface
1108660 USA Min Busenbark Surface only
664669 Private Surface & Mineral Busenbark
(SS6) STATE LAND EGH PP applied 6/27/80
STATE LAND (SS1) EGH PP applied 6/27/80
T17S R.25E
T18S R25E
T.18 S. R25E.
N
PARCELS OWNED OR CONTROLLED BY PLATORO MINES, INC.
PARCEL NO. 1 THETFORD PATENT CLAIM GROUP
PARCEL NO. 2 BEN BROWN PATENT CLAIM GROUP
PARCEL NO. 3 PLATORO MINES CLAIM GROUP - LODE CLAIMS
PARCEL NO. 4 BUSENBARK PRIVATE LAND GROUP (SURFACE only)
PARCEL NO. 5 HERNADEZ CLAIM GROUP (APPROX. LOC.)
PARCEL NO 6 BUSENBARK PRIVATE MINERAL AND LAND GROUP
QCD by Platoro to Cor-Ford, Inc 6-27-77
HERNANDEZ Readjustment per W. BROWN 5-7-76
HERNANDEZ Readjustment according to map given to Leo Smith & Reportedley on file with B.L.M, Cartmell Bros.
PLATORO MINES INC.
COMMONWEALTH MINE
PEARCE ARIZONA
CLAIM LOCATION MAP
SCALE 1"=
BY: BILL BROWN
DATE: MAY, 1975.

Found in Field PAN 66
William G Brown
105-1490N
Located 5-12-76

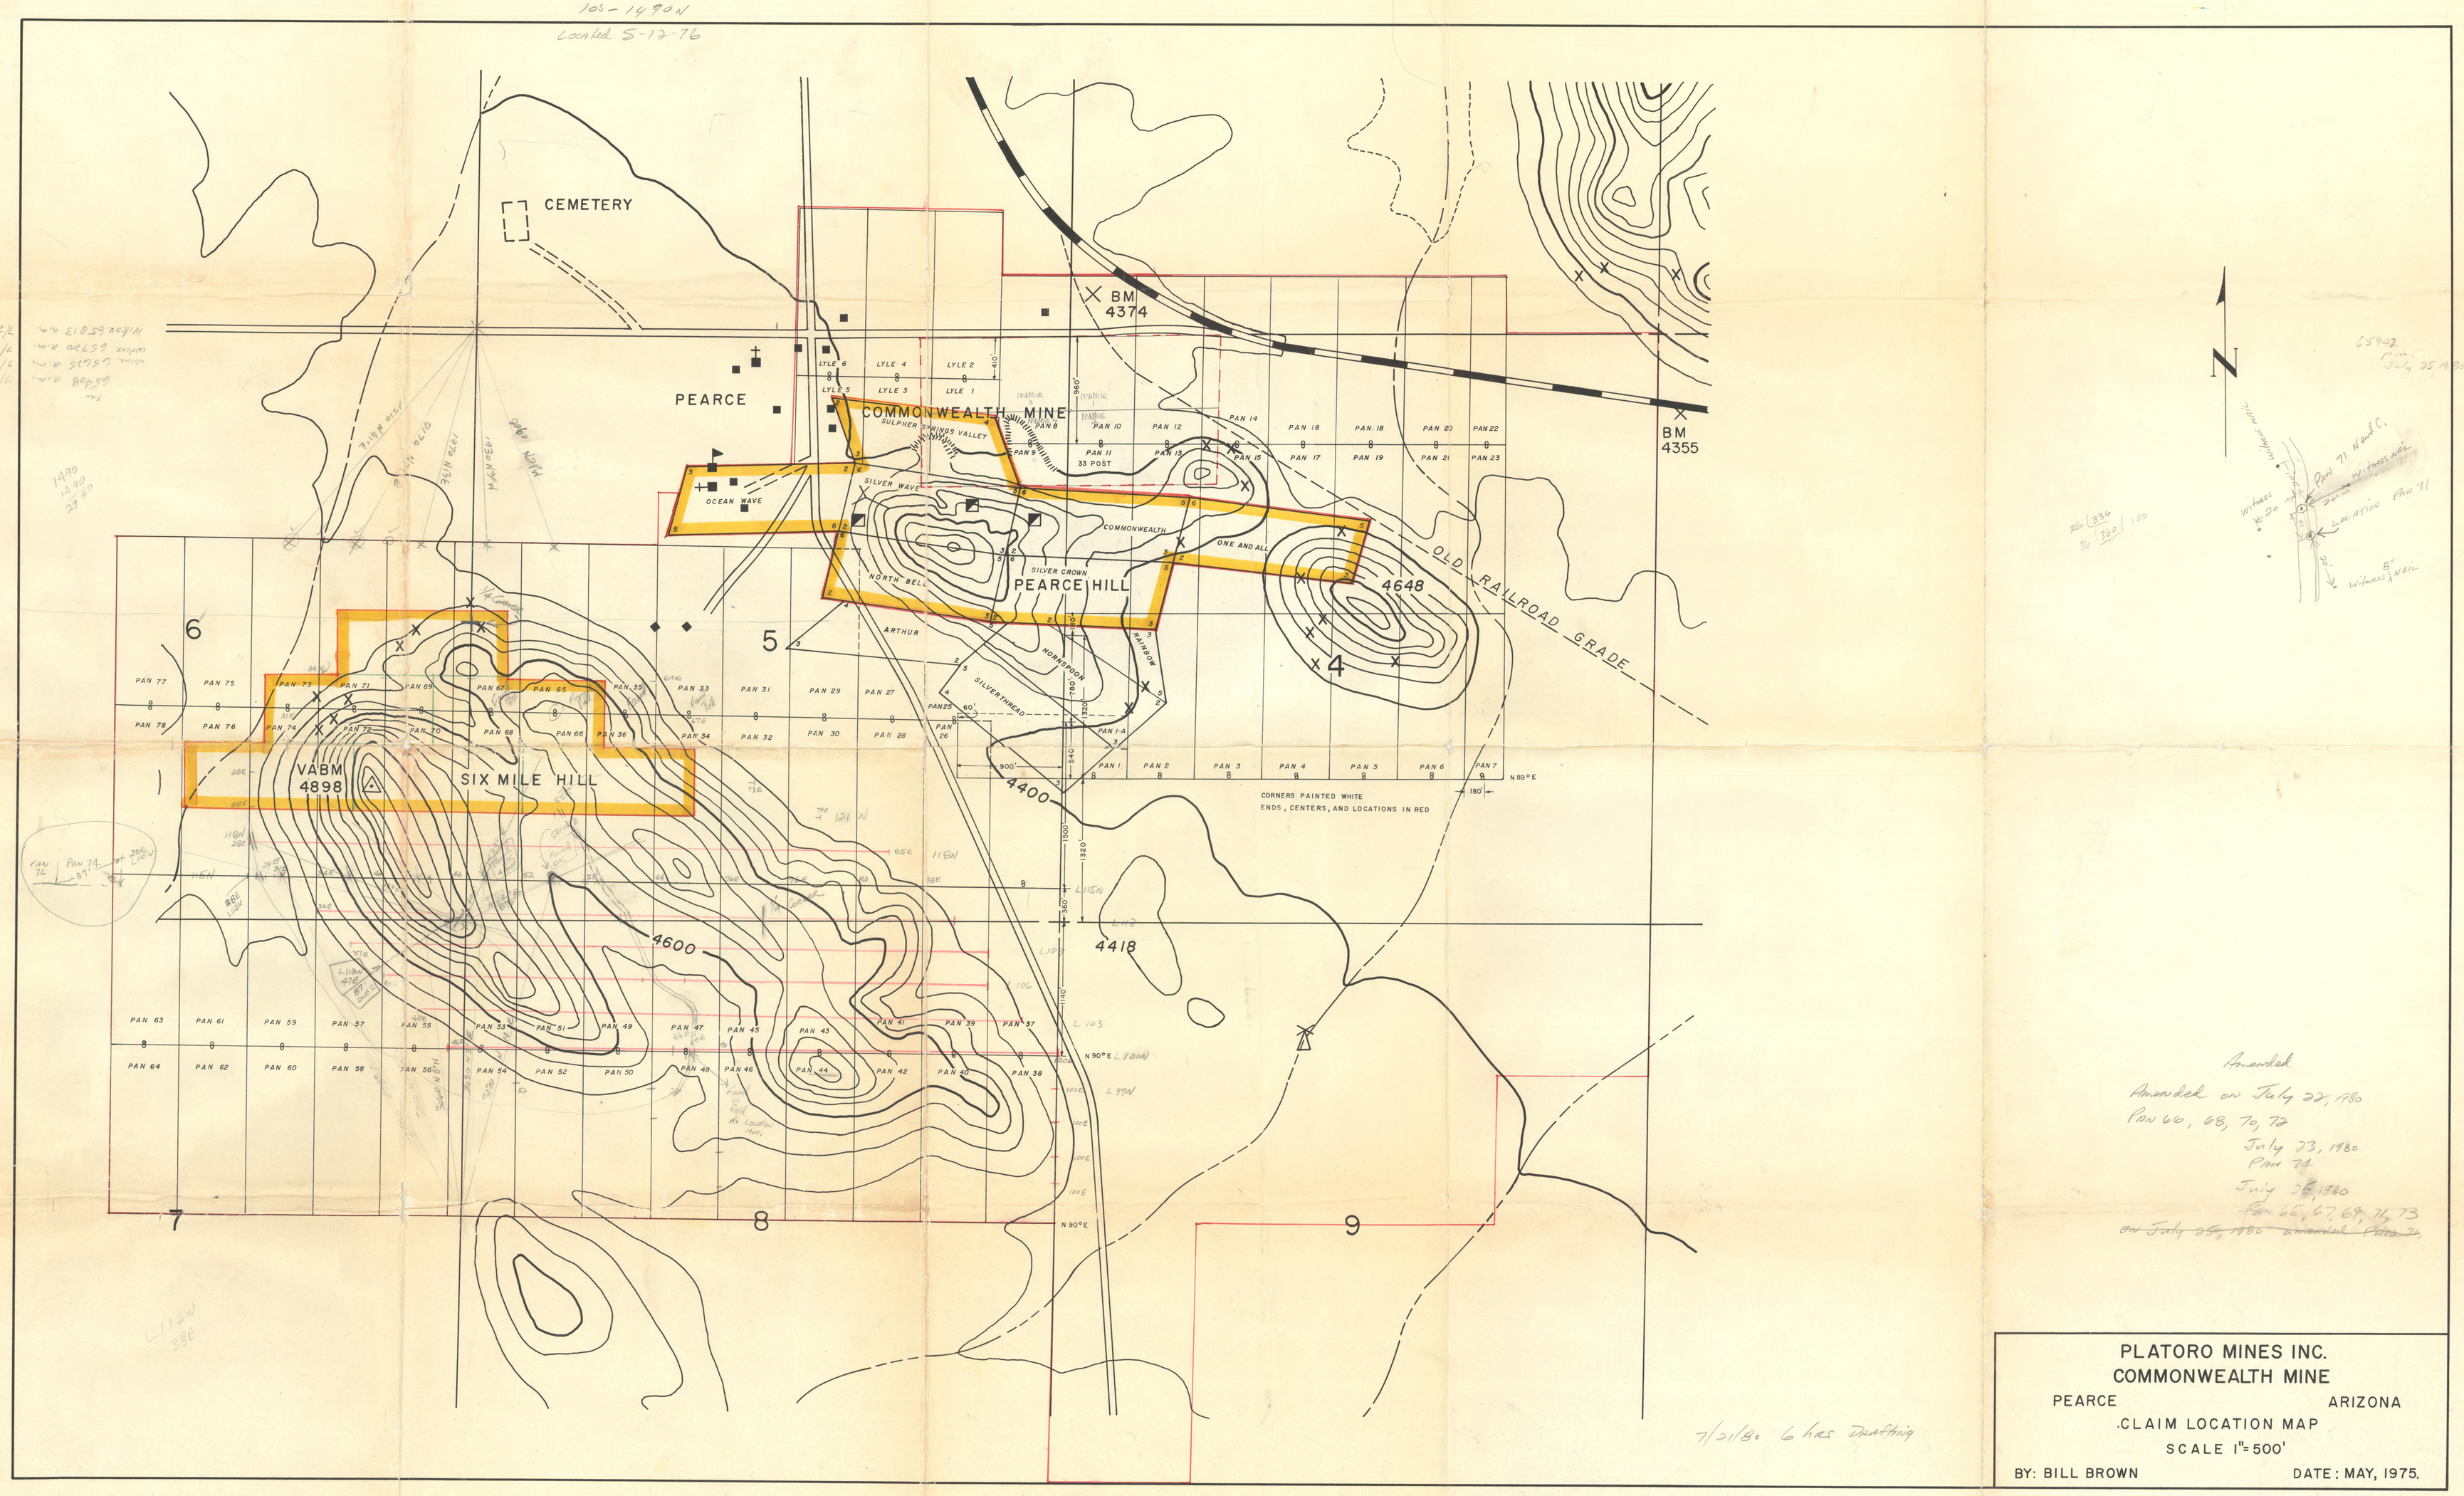

Amended
Amended on July 22, 1980
Pan 66, 68, 70, 72
July 23, 1980
Pan 74
July 25, 1980
~~Pan~~ 65, 67, 69, 71, 73
~~on July 25, 1980 amended Pan 74~~

7/21/80 6 hrs Drafting

PLATORO MINES INC.
COMMONWEALTH MINE
PEARCE ARIZONA
CLAIM LOCATION MAP
SCALE 1"=500'
BY: BILL BROWN DATE: MAY, 1975.

Robinson Geologic Map
1980

CEMETERY

PEARCE

COMMONWEALTH MINE

SULPHER SPRINGS VALLEY

BM 4374

BM 4355

OCEAN WAVE

SILVER WAVE

COMMONWEALTH

ONE AND ALL

SILVER CROWN

NORTH BELL

ARTHUR

HORNSTOOL

MARROW

SILVERTHREAD

PEARCE HILL

4648

OLD RAILROAD GRADE

VABM 4898

SIX MILE HILL

4600

4400

4418

CORNERS PAINTED WHITE
ENDS, CENTERS, AND LOCATIONS IN RED

LEGEND
- Fault
- Veins
- Qal
- Ta3
- Tf3
- Ta2
- Tw3

Robinson Geologic Map 1980

PLATORO MINES INC.
COMMONWEALTH MINE
PEARCE ARIZONA
CLAIM LOCATION MAP
SCALE 1"= 500'
BY: BILL BROWN DATE: MAY, 1975.

COMPILED BY: E.G. HEINRICHS	DRAFTING: J. DOWNS	DATE: JANUARY 1981

REVISIONS

File A-4

NO.	DATE	BY	REMARKS
1	30/3/81	E.G.H.	GRID SYSTEM UPDATED.
2	5-5-81	EGH	UNIMPROVED RDS. updated - Pearce Claims added
			Platoro Fee Simple and added
3	4-83	EGH	up date

AMENDED CLAIM LOCATION MAP
OF
PEARCE PROJECT
COCHISE COUNTY, ARIZONA
FOR
MR. JOHN A. STEPHENS
BY
E. GROVER HEINRICHS & ASSOCIATES
1802 W. GRANT RD., SUITE 110-4, TUCSON, AZ. 85705

PLATORO MINES INC.
COMMONWEALTH MINE
PEARCE ARIZONA
CLAIM LOCATION MAP
SCALE 1"=500'
BY: BILL BROWN DATE: MAY, 1975.

File A-4